


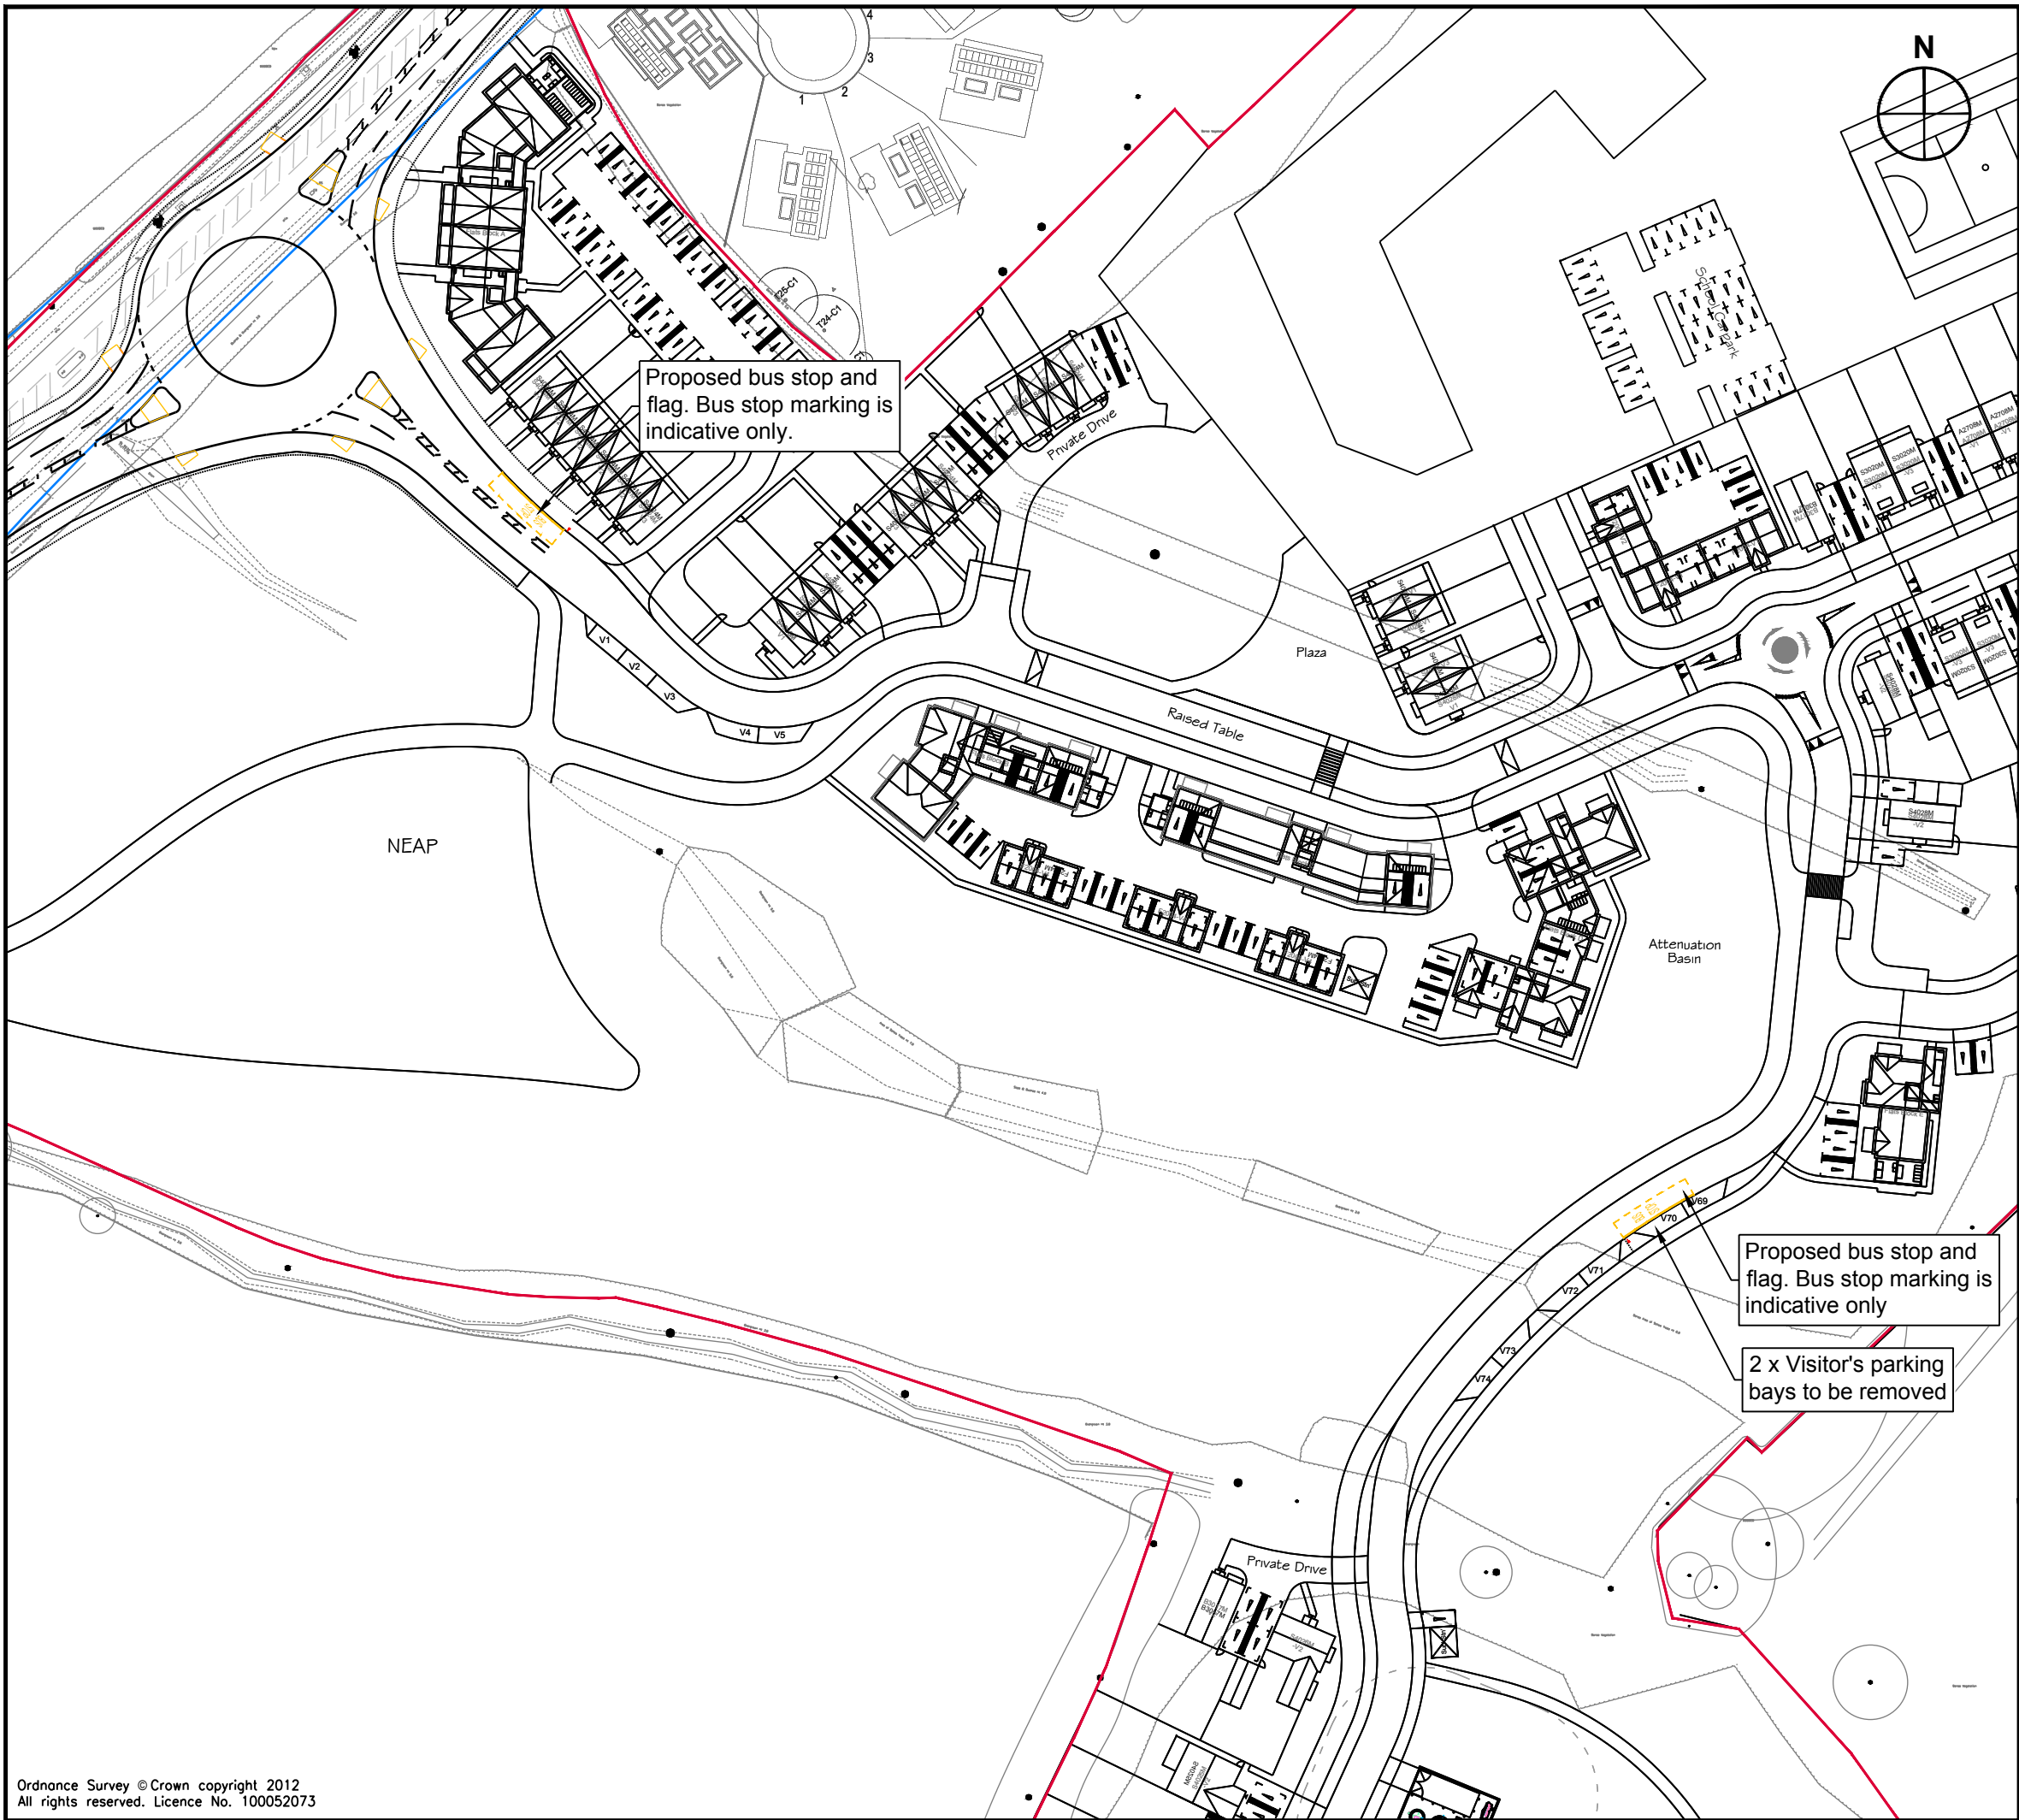

Notes:

- 1. This is not a construction drawing and is intended for illustrative purposes only.
- 2. White lining is indicative only.
- 3. Proposed layout is based on Finc Architects plan : _400K_Shenfield Proposed Site Layout.

Key

Red Line Boundary

REV.	DETAILS	DRAWN	CHECKED	DATE
-	-	-	-	-

STATUS:

INFORMATION ONLY

CLIENT:

Croudace Homes Ltd

PROJECT:

Officers Meadow, Shenfield

DRAWING TITLE:

Proposed Internal Site Bus Stops

SCALES:

1:1000 at A3

DRAWN:	NS	CHECKED:	TF	DATE:	23.04.2024
--------	----	----------	----	-------	------------



DRAWING NUMBER:

152080/PD23

REVISION:

-